


4/18/88\_

AS BUILT

F-86-69

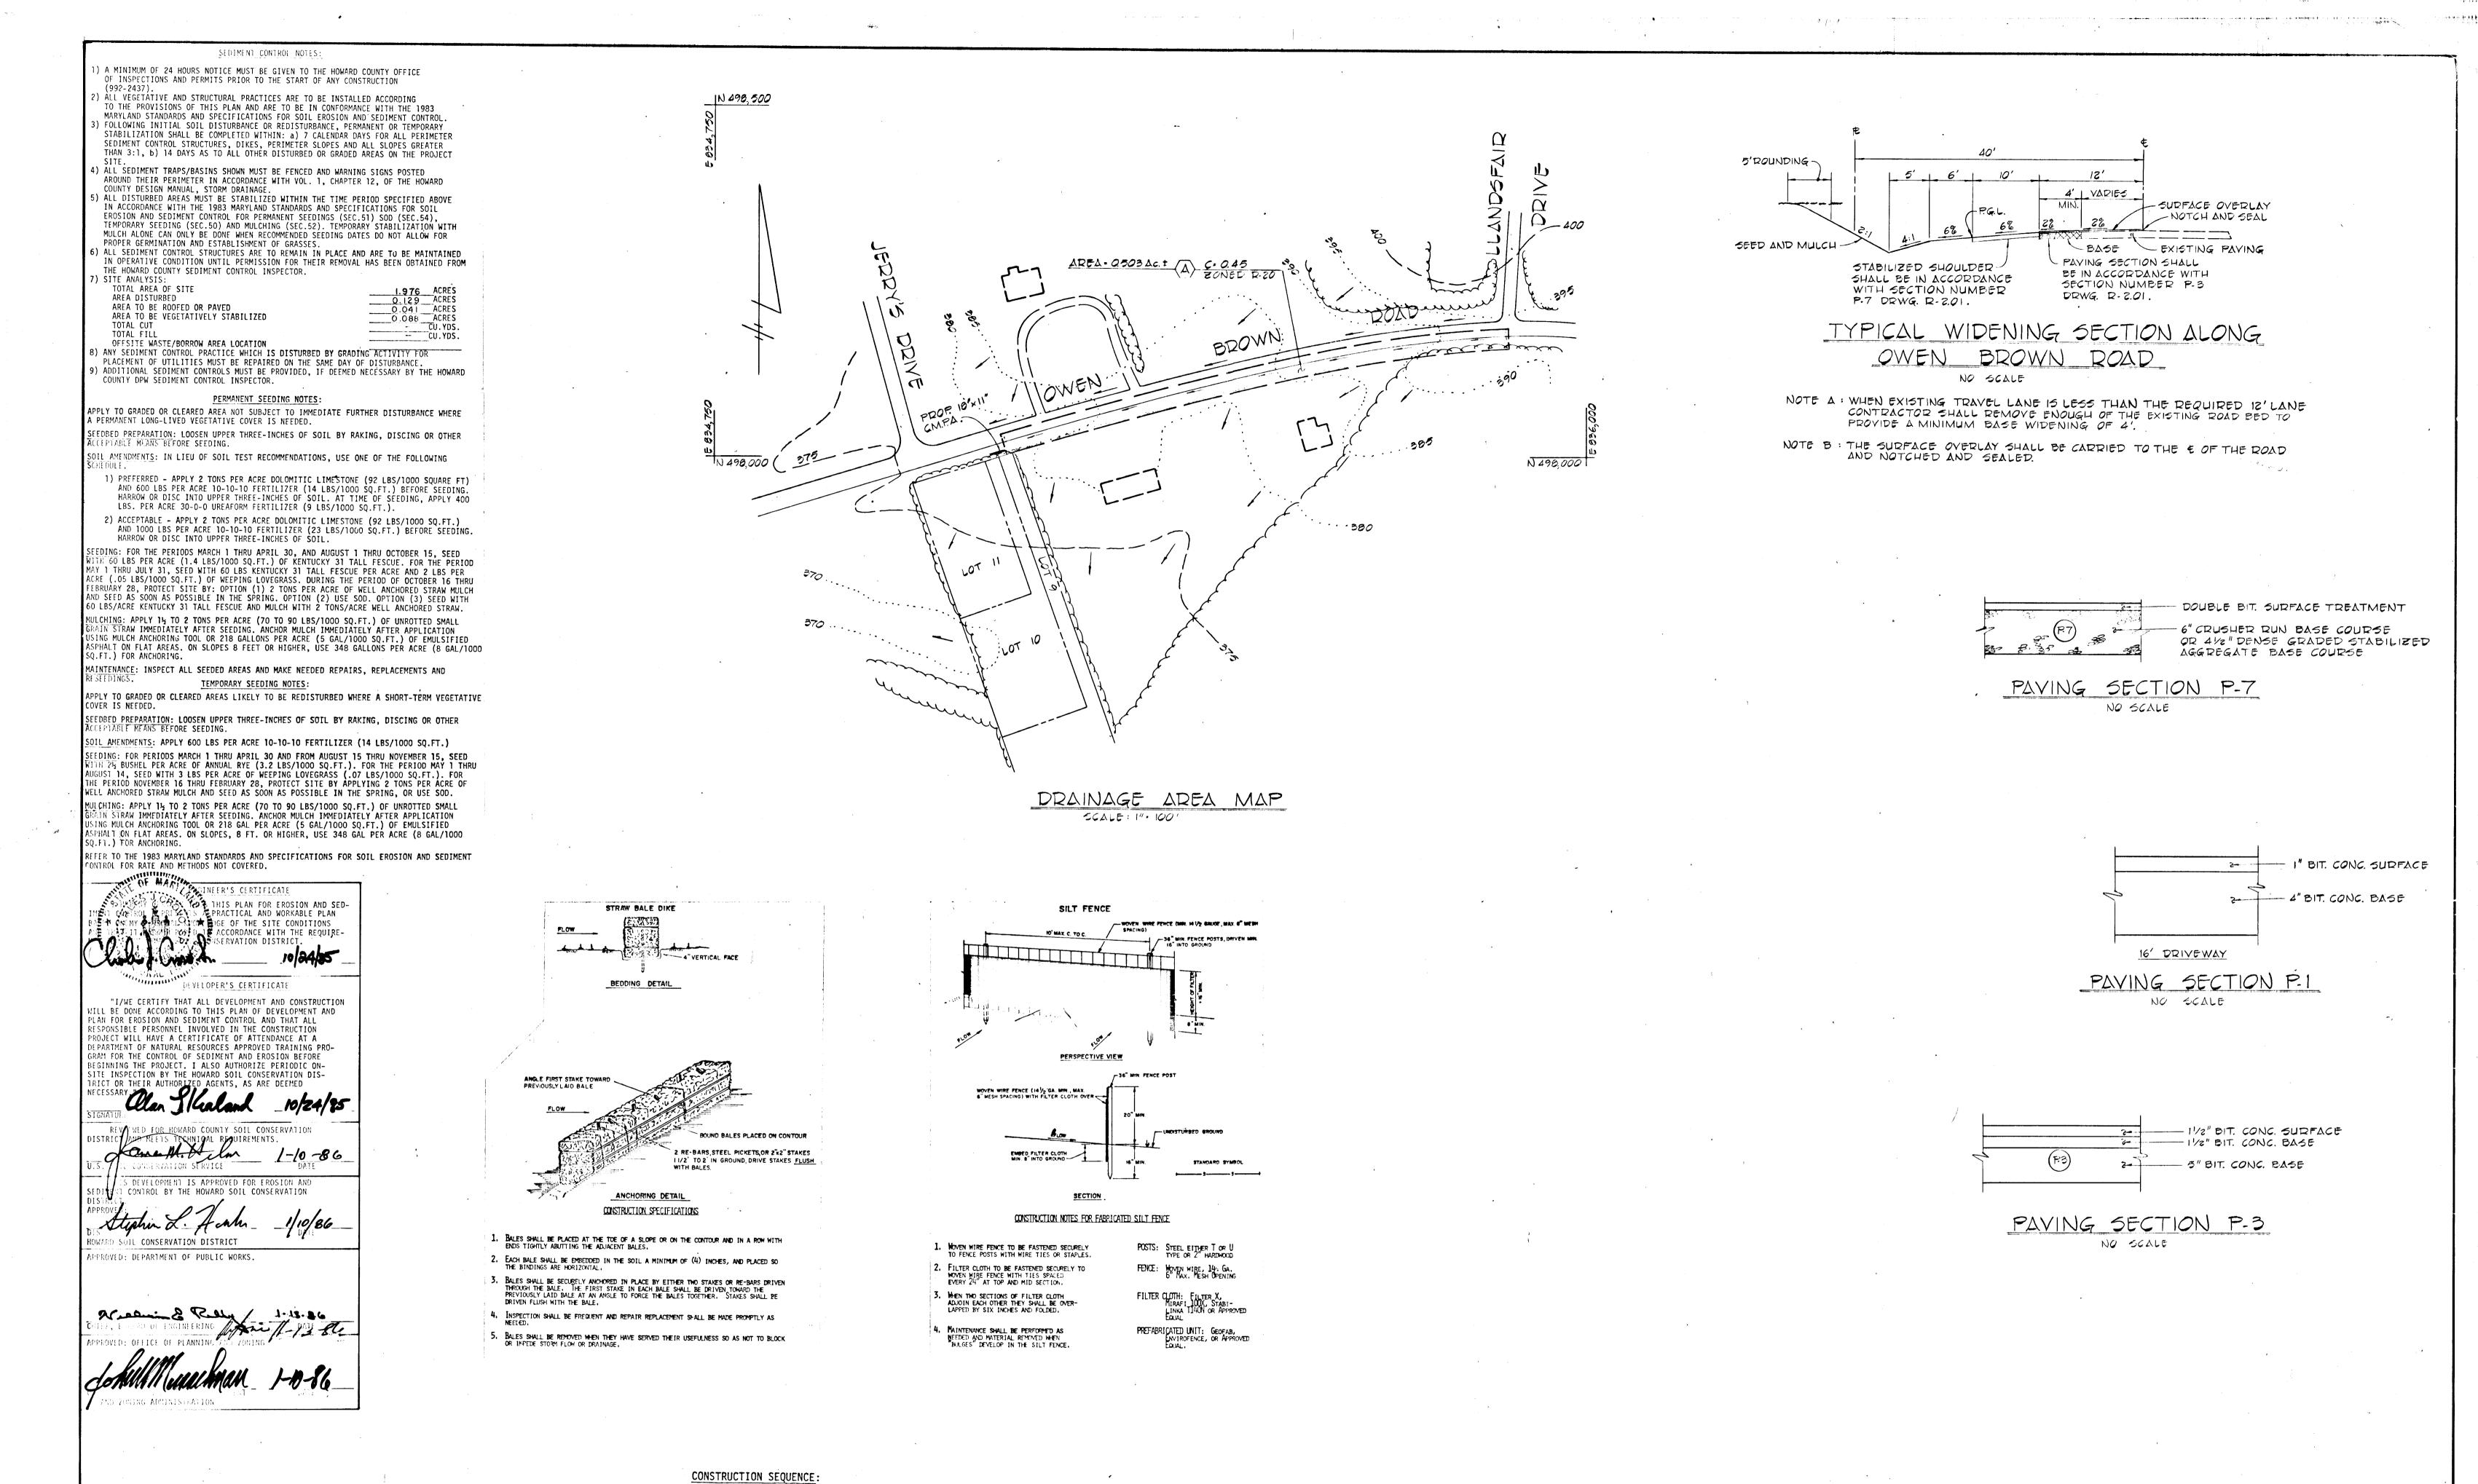

FISHER, COLLINS & CARTER, INC.

CIVIL ENGINEERS & LAND SURVEYORS 8388 COURT AVE.

ELLICOTT CITY, MD. 21043 (301) 461 - 2855

OBTAIN GRADING PERMIT.

2. PLACE STRAW BALE DIKES IN THE EXISTING DRAINAGE DITCH

IN FRONT OF THE EXISTING DRIVEWAY.

3. GRADE ROAD WIDENING, SHOULDER, AND DRAINAGE DITCH IN ACCORDANCE

WITH THE ROAD WIDENING DETAIL.

4. DURING CONSTRUCTION ALONG OWEN BROWN ROAD CONTRACTOR SHALL

PLACE STRAW BALES OR SILT FENCE DOWNGRADE OF ANY DISTURBED AREAS AT THE END OF EACH WORKING DAY. LAY BASE COURSE FOR ROADWAY AND SHOULDER AREAS.

6. CLEAN BASE COURSE, APPLY TACK COAT TO BASE COURSE. AND LAY SURFACE COURSE FOR ROADWAY AND SHOULDER AREAS. STABILIZE ALL SHOULDERS USING PERMANENT SEEDING. 7. ALL DISTURBED AREAS DUE TO REMOVAL OF SEDIMENT CONTROL MEASURES

SHALL BE GRADED AND STABILIZED BY PERMANENT SEEDING.

OWNER ALAN P. KURLAND 10382 ECLIPSE WAY COLUMBIA, MD. 21044

DEVELOPER HERITAGE HOMES **S**UITE 210 8950 MD. ROUTE 108 COLUMBIA, MD. 21045

DRAINAGE AREA MAP, ROAD SECTION. SEDIMENT CONTROL NOTES & DETAILS

KURLAND PROPERTY

LOTS 9-11

FIFTH ELECTION DISTRICT HOWARD COUNTY, MARYLAND

SCALE: AS SHOWN OCTOBER 22, 1985 SHEET 2 OF 2